
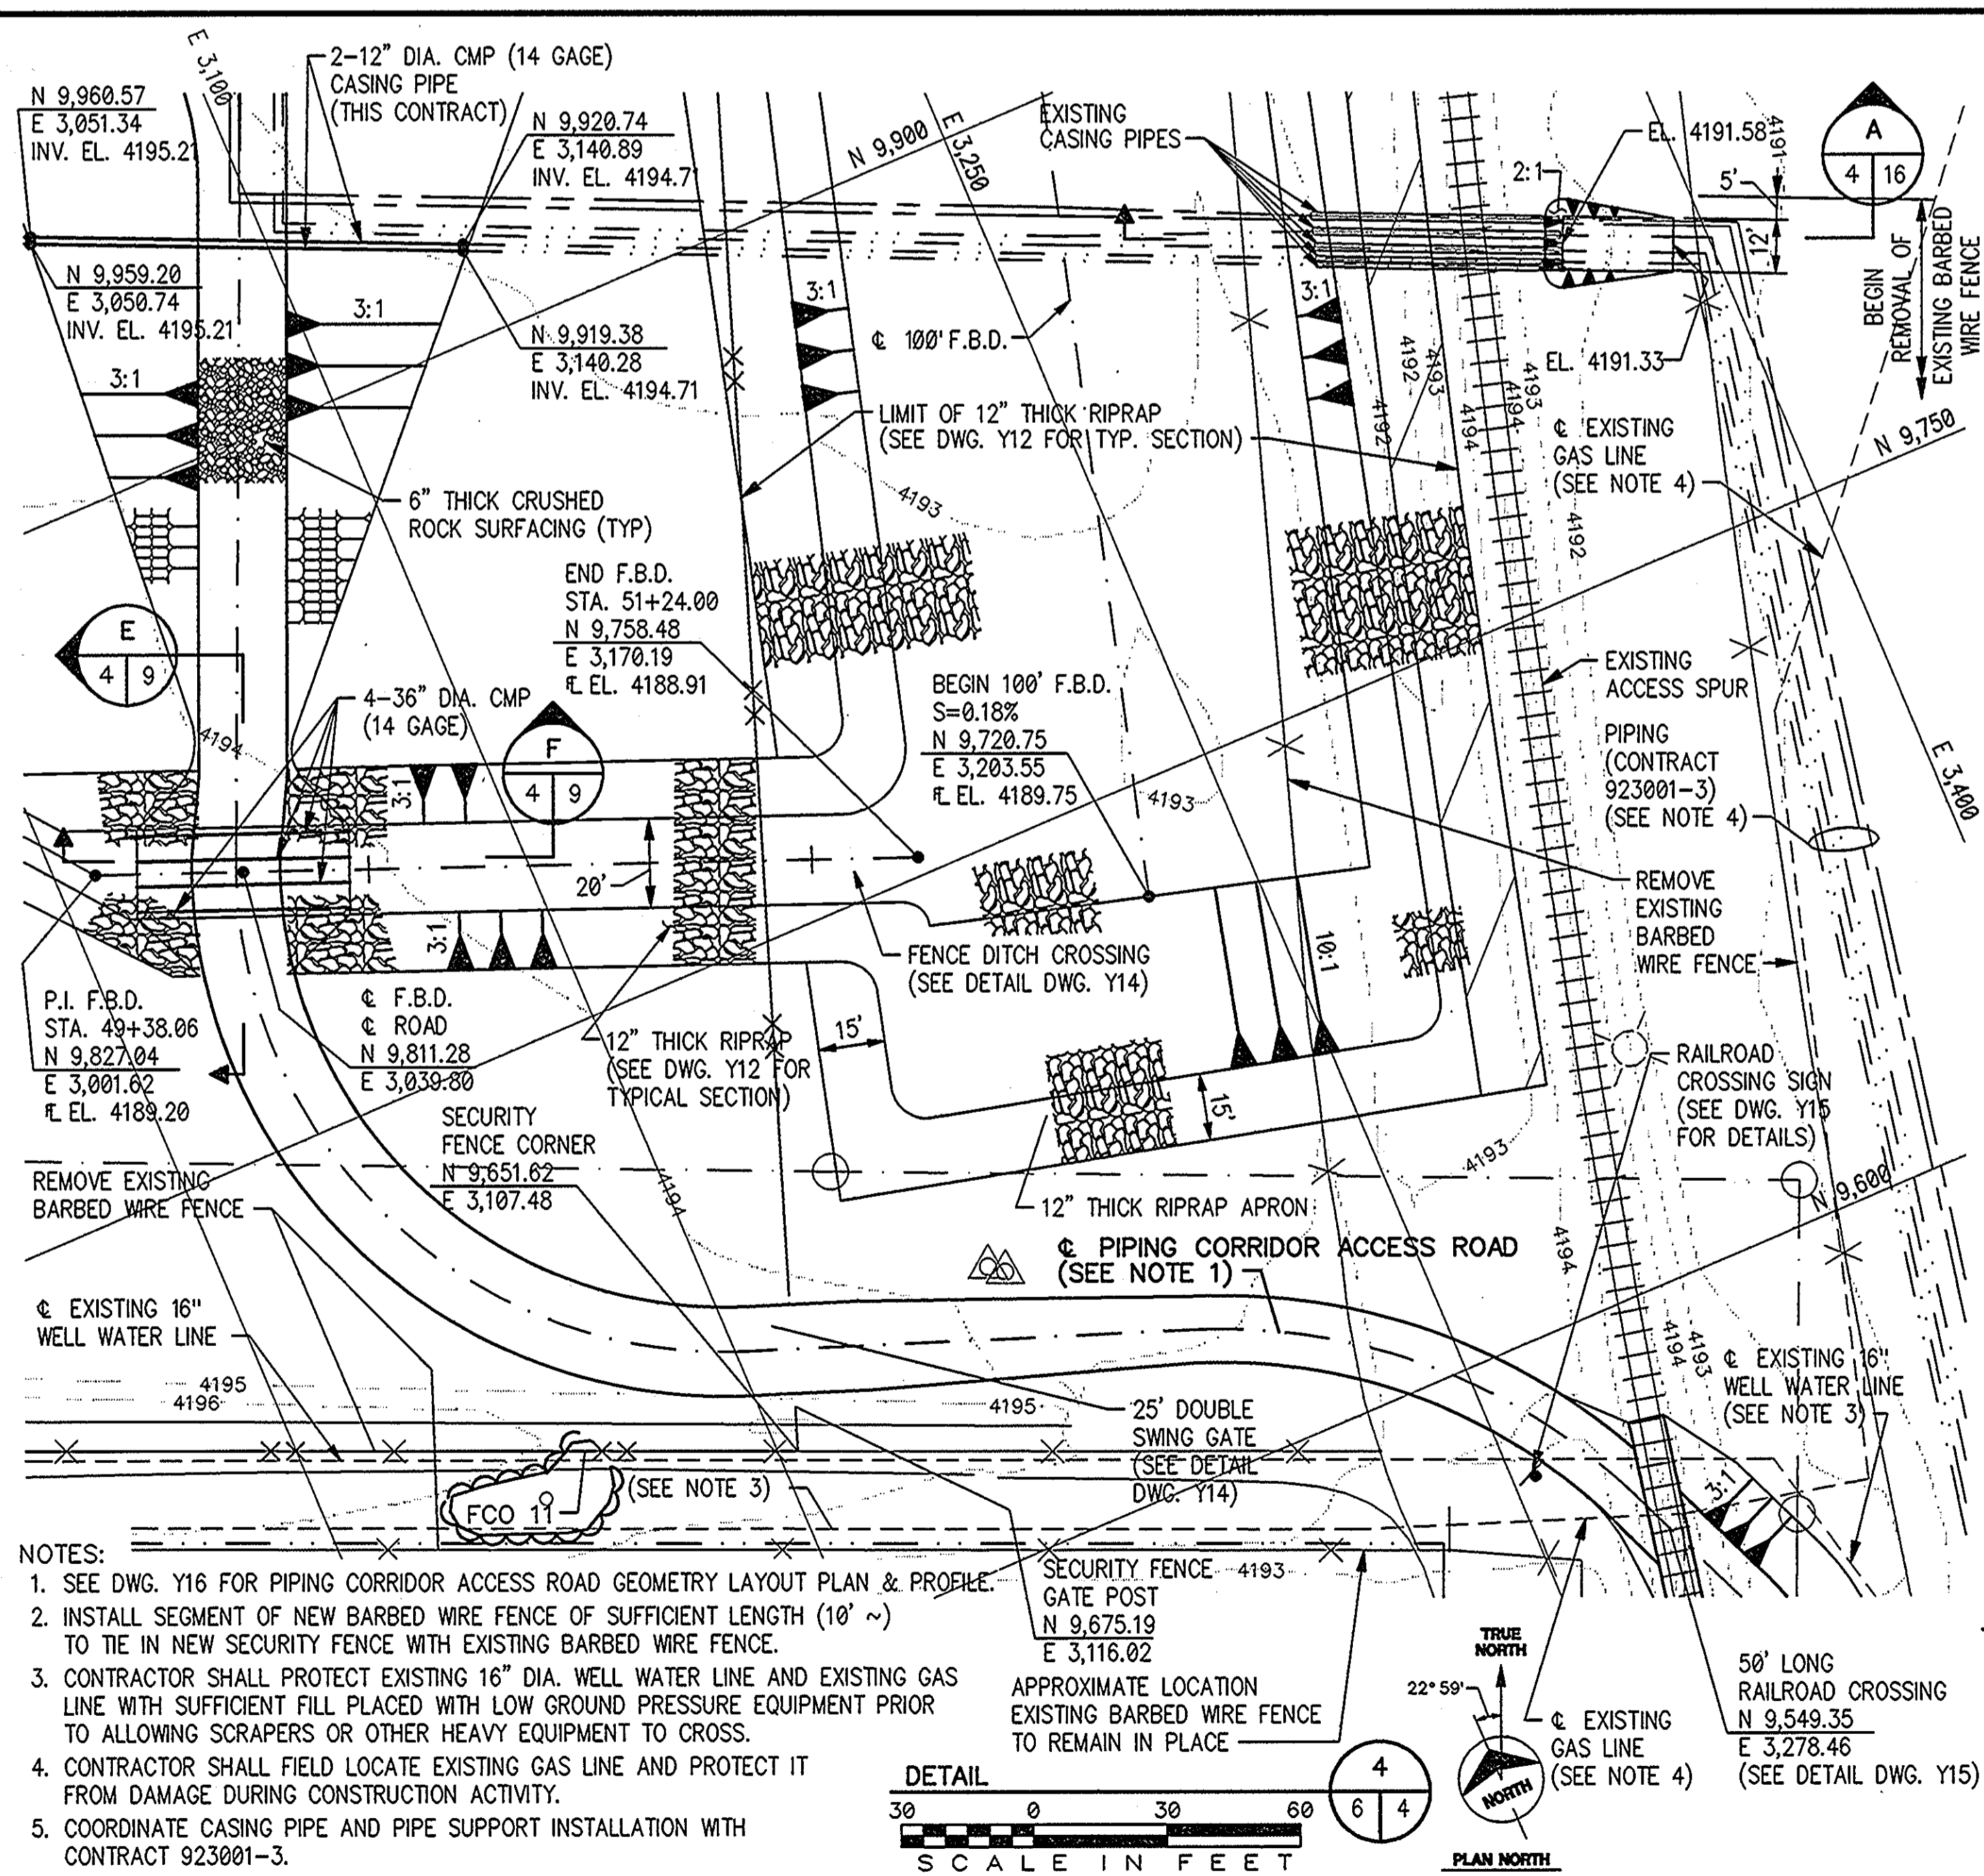


| no. | date | by | revision |
|-----|---------|-----|------------------------------------|
| 0 | 3-10-94 | TLL | ISSUED TO OWNER FOR BID |
| 0 | 9-20-94 | TLL | ISSUED AS BID |
| 1 | 4-8-95 | DLM | CONFORMING TO CONSTRUCTION RECORDS |
| B | 1/24/97 | CRM | DCN 96/104, C. Reese / C. Walling |

NOTE : REFER TO DWG. Y22 FOR WASTE POND

GRADING PLAN - AREA 2

Scale for Microfilm

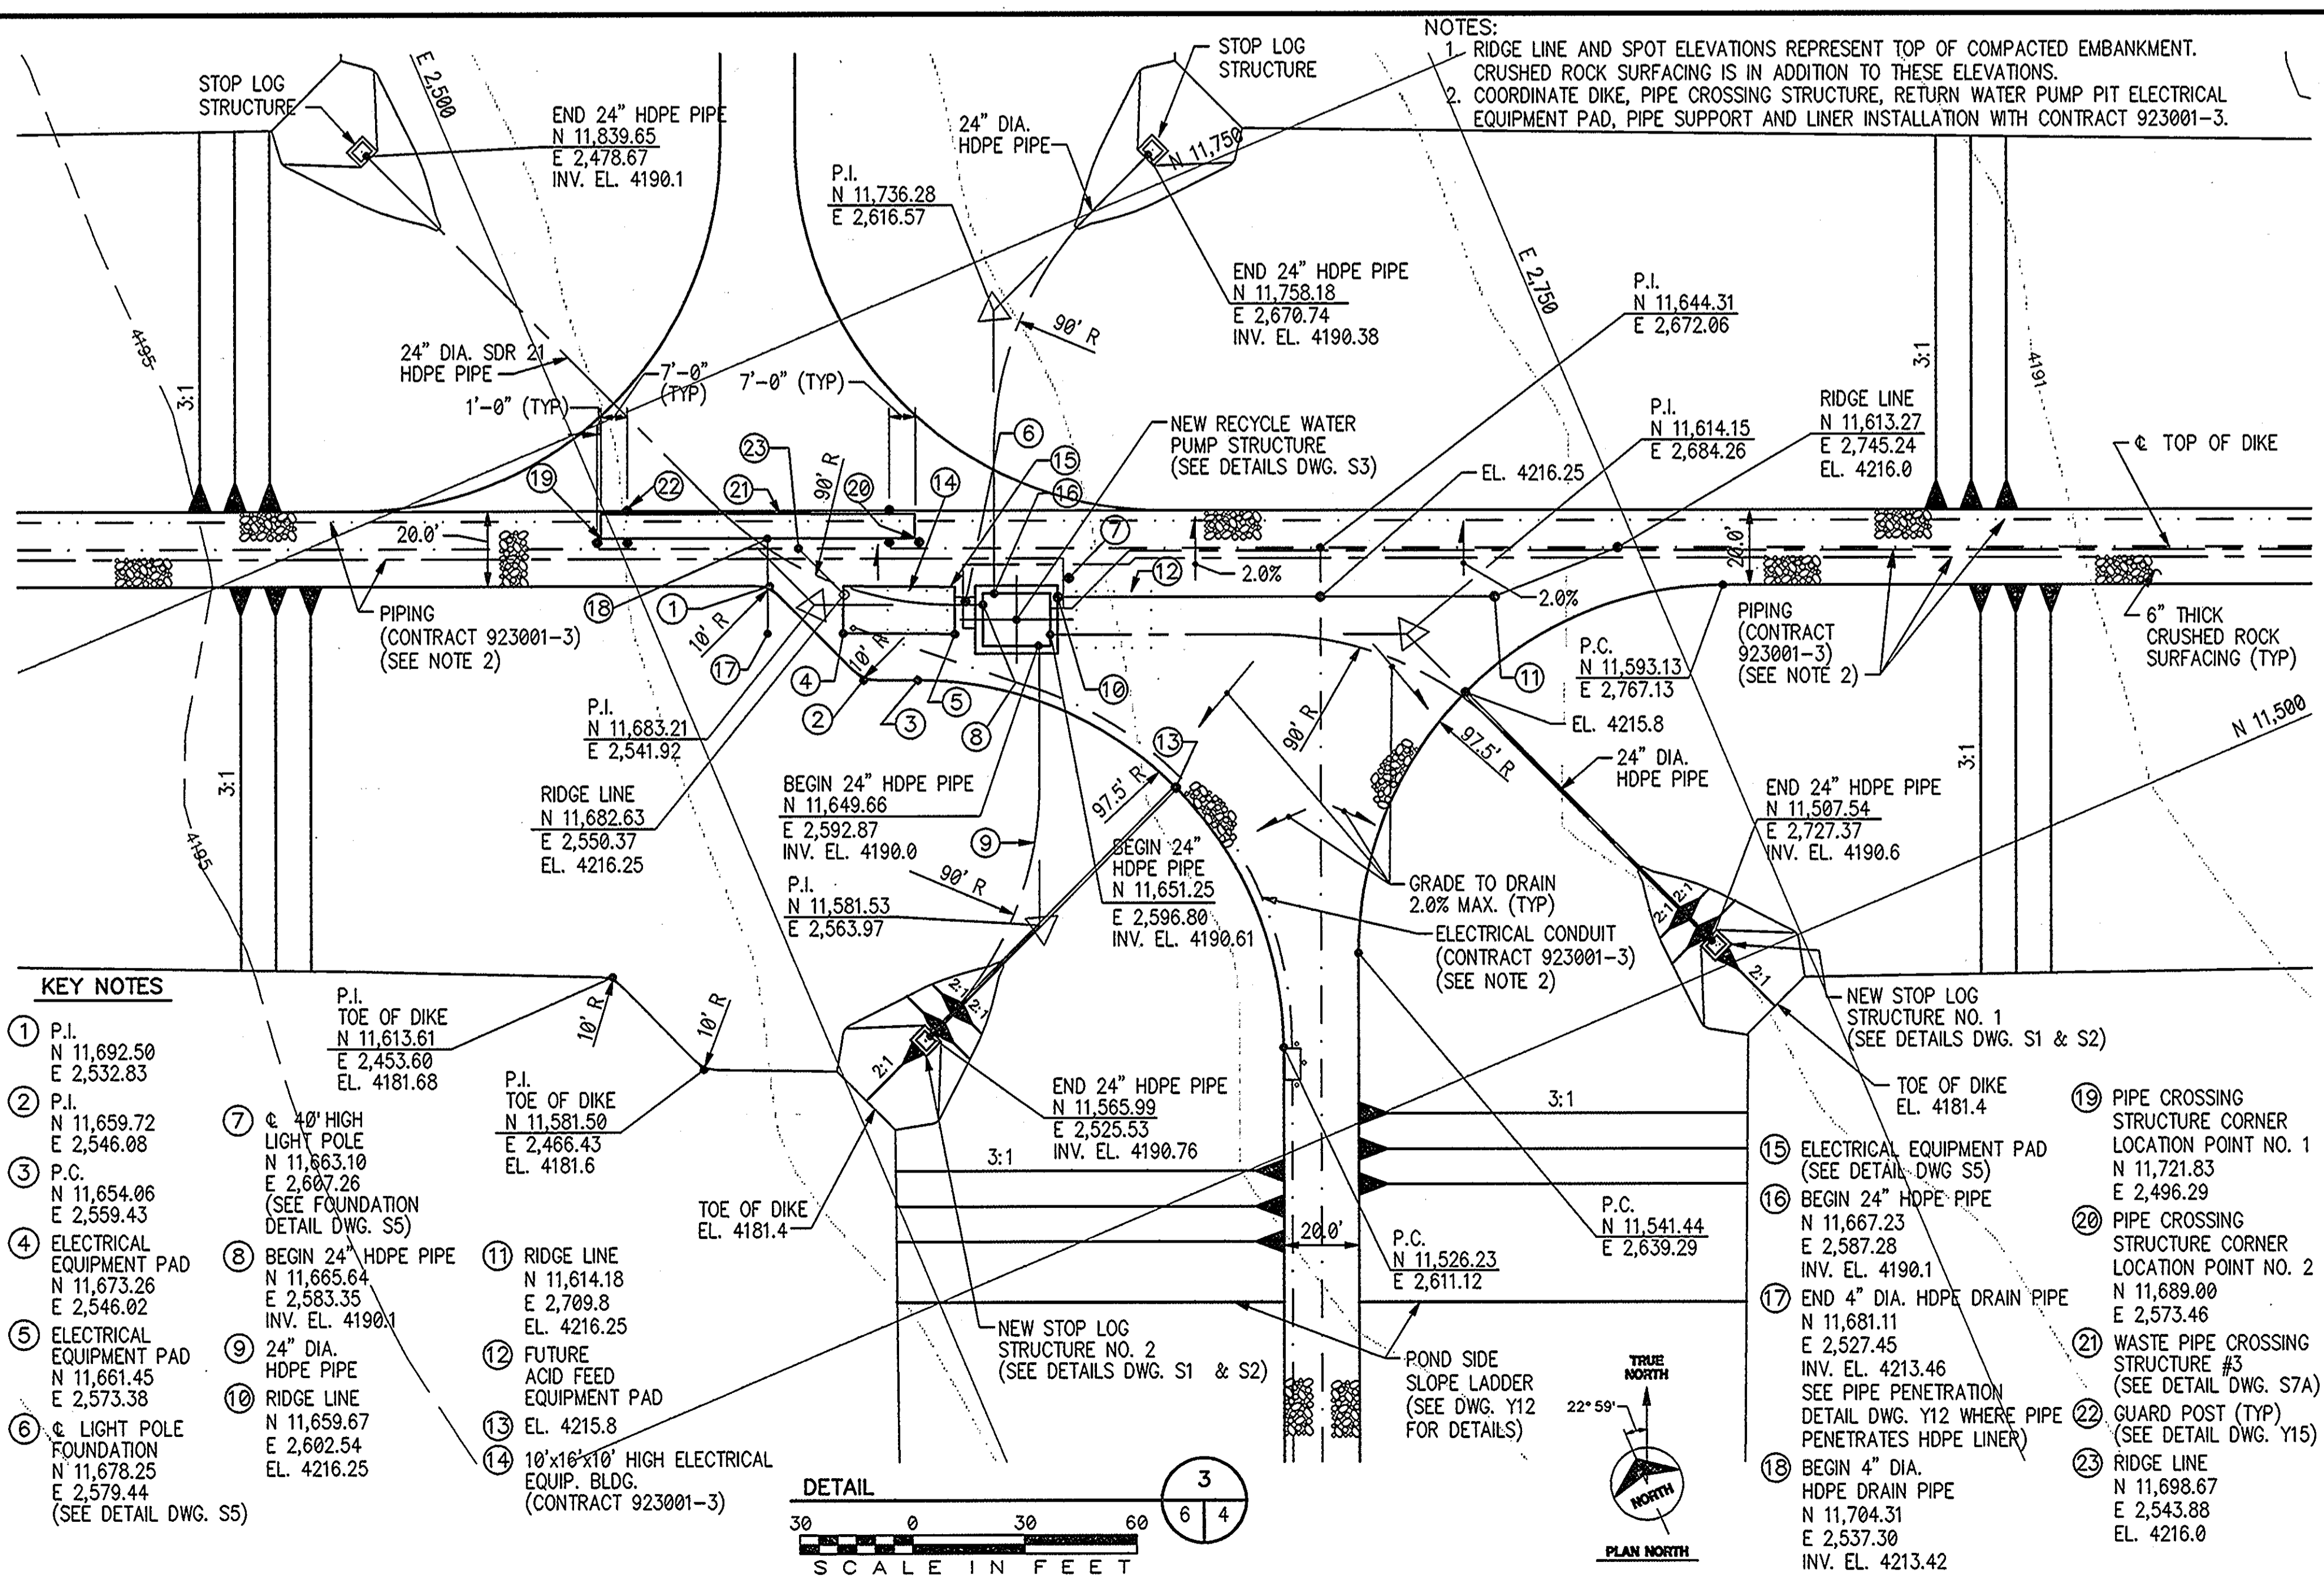

Burns & McDonnell

date JULY 29, 1992 detailed D. MADDOCK
 designed M. FRERKING checked T. LARSON

AEPCO ARIZONA ELECTRIC POWER COOPERATIVE, INC. APACHE STATION
 COMBUSTION WASTE DISPOSAL FACILITY
 WASTE DISPOSAL PONDS AND APPURTENANCES CONSTRUCTION

WASTE POND GRADING PLAN AREA 2
 project 91-033-1-010 contract 923001-2
 drawing Y4 - 1 rev. 1
 sheet of sheets